Views Of Entry At 2nd Floor

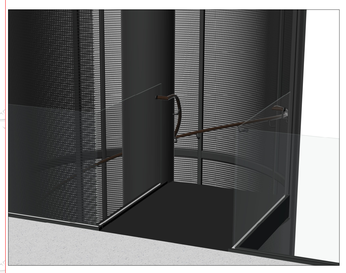

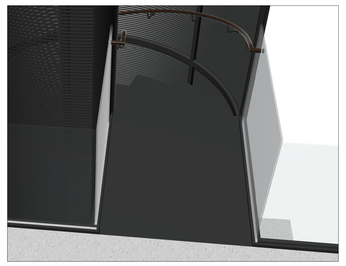

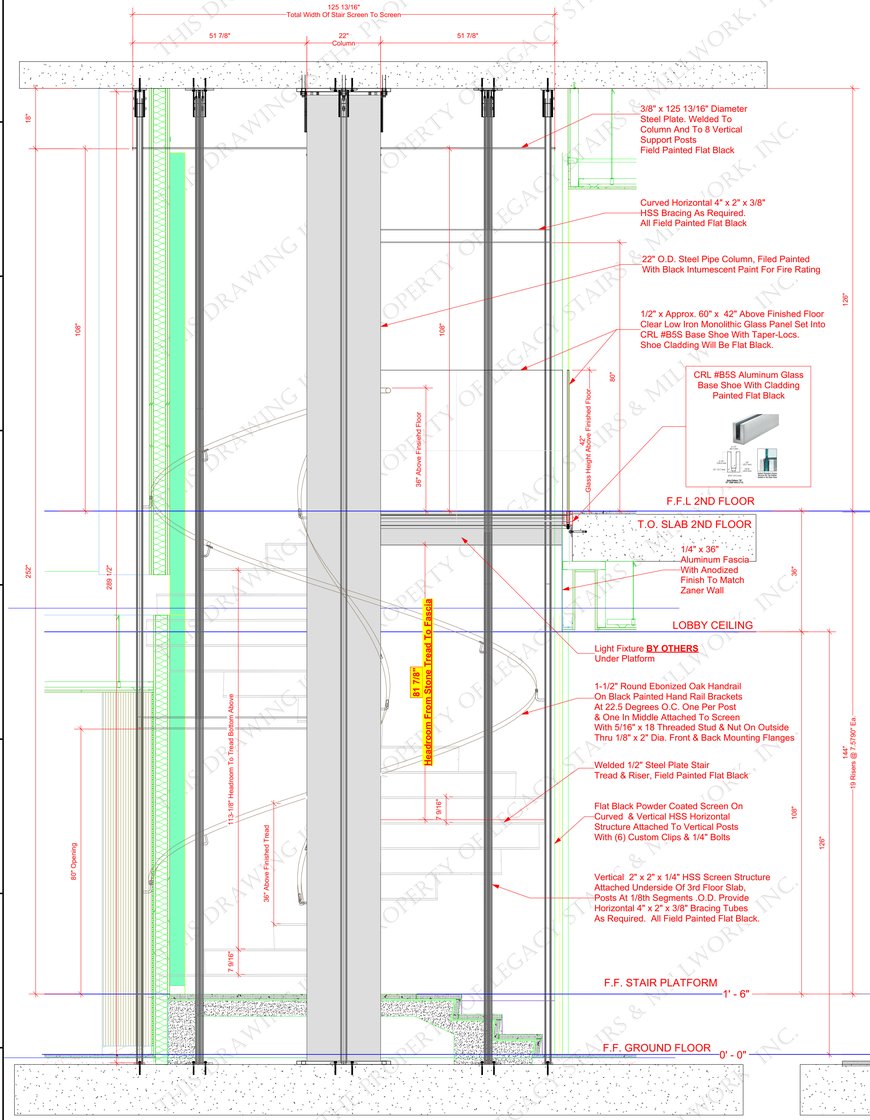

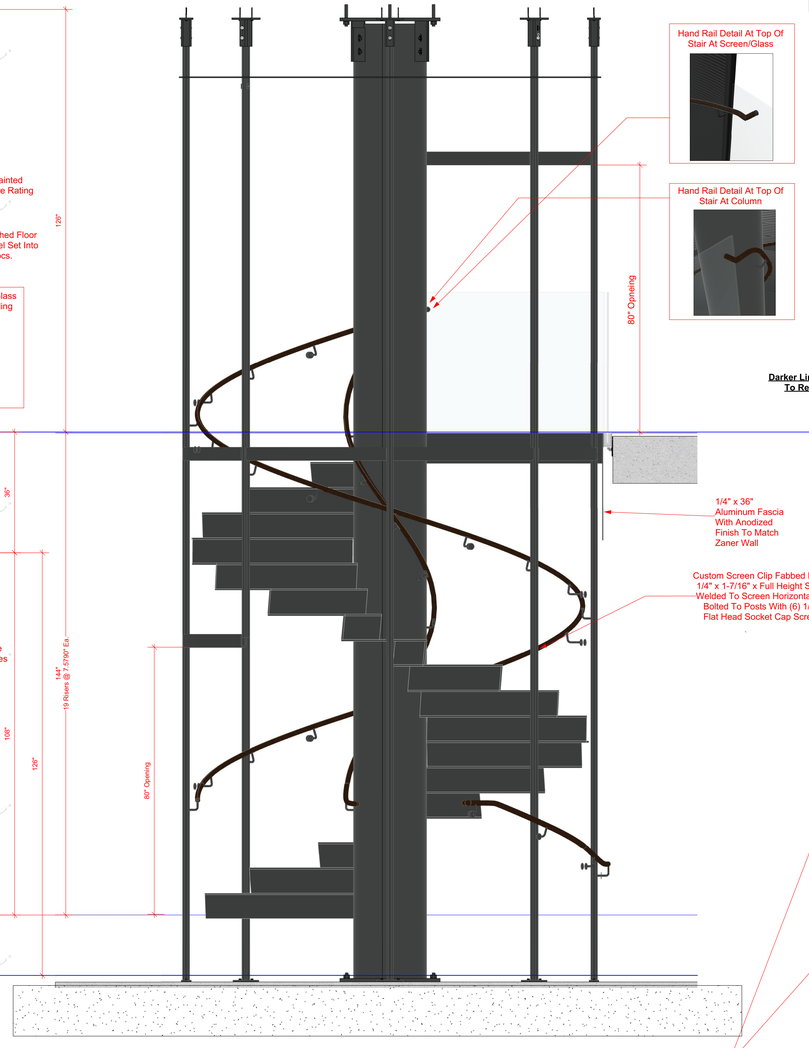

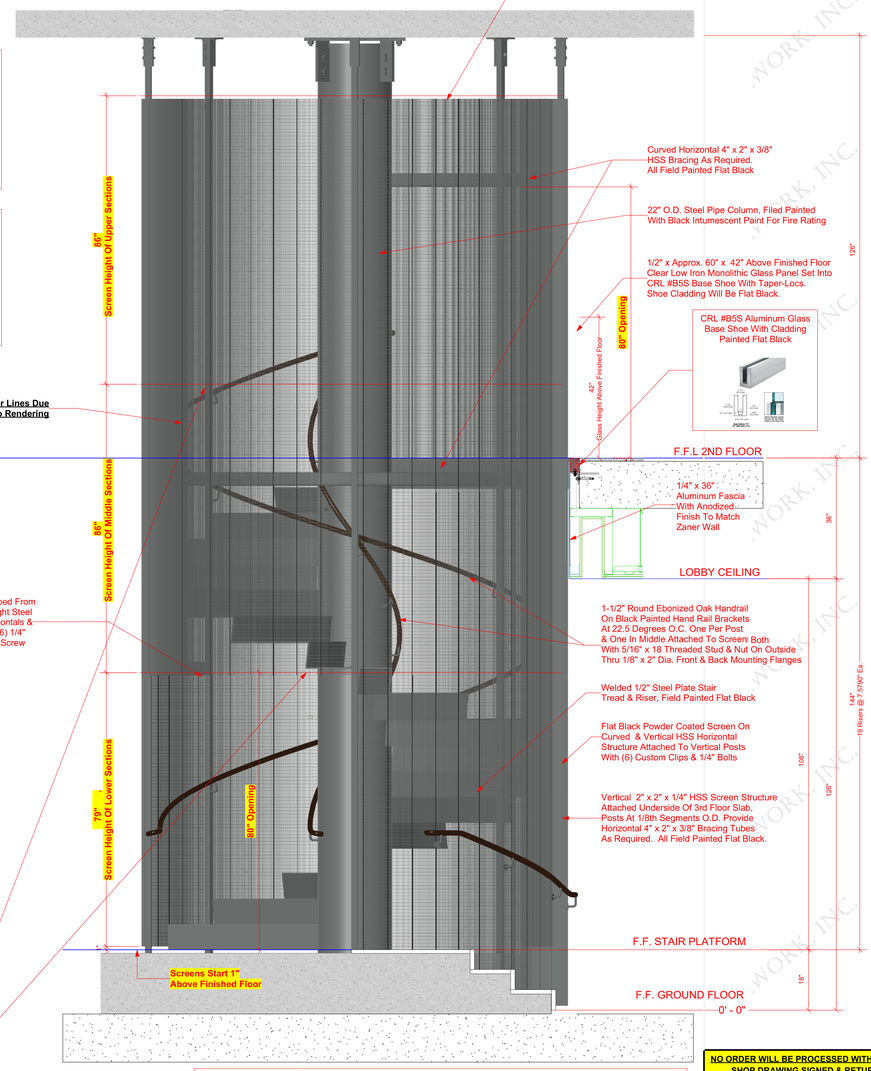

NOTE TO CUSTOMER:
Due To Industry Standard Fabrication Tolerances
The Vertical Wires Of Screen Panels
WILL NOT Align At The Two Horizontal Locations
Where Panels Meet From Section To Section

View Of Entry At 1st Floor

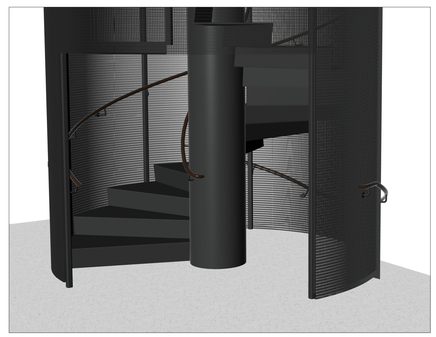

1 / 1 Elevations With 3D Renderings
Scale: 3/4" = 1'-0"

NO ORDER WILL BE PROCESSED WITHOUT THIS SHOP DRAWING SIGNED & RETURNED

NAME: _____ (sign)
NAME: _____ (print)
TITLE: _____
DATE: _____

This Drawing Is The Property Of

LEGACY STAIRS & MILLWORK, INC.
5004 Industrial Road • Wall, NJ 07727
Phone 732-905-7705 • Fax 732-905-7750

Production Title: Consigli Greenpoint Landing New York City, NY

Drawing Title: Lobby Stair Elevations AS BUILT

Designer: SJH	Director: Andrew Schwartz
Drawn By: SJH	Scale: 3/4" = 1'0"
Venue:	Drawing No.: 2 of 6
Date: 11-22-22	
CAD File Name: CONSIG-4479	

THIS DRAWING IS THE PROPERTY OF LEGACY STAIRS & MILLWORK, INC.